



8	Lambert 4	Lambert 4
36	587242.1	182721.2
38	587268.1	182707.9
48	587307.4	182812
49	587289.8	182789.7

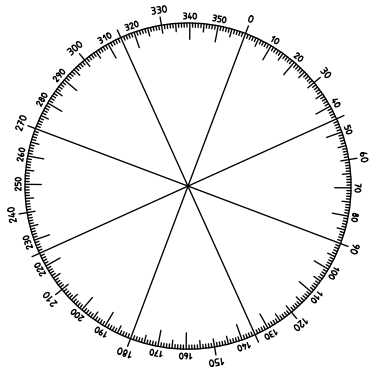

CÔTÉ EXTERIEUR (RIVAGE)

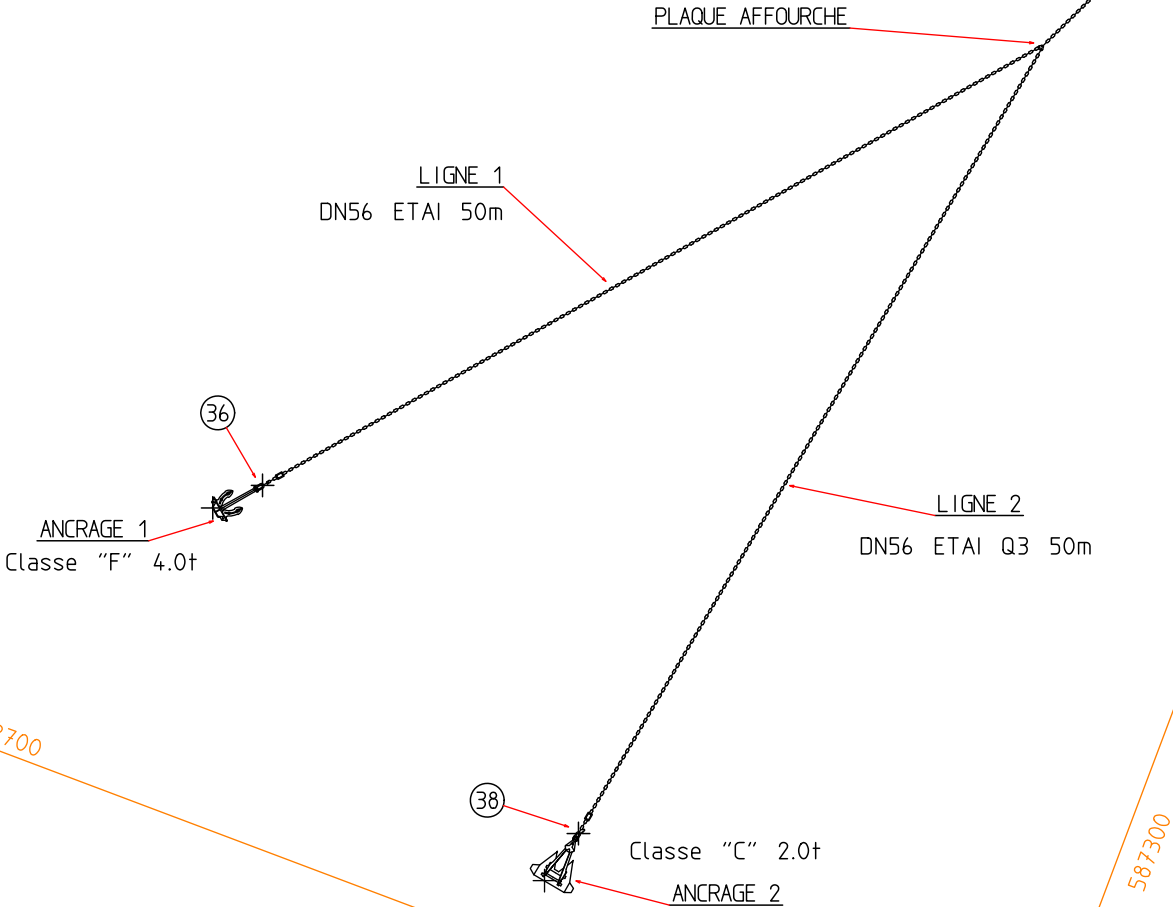

CÔTÉ NAVIRE & SEA-LINE

Rev 0

ECHELLE 1/500	MOUILLAGE BA 126 SOLENZARA-SW	Plan:SLZ1-SW-REC	0
		Date: 14 DEC 17	
		Modif: -	
A 4	RECOLEMENT MOUILLAGE SUD OUEST		
DAVID HENRY ARCHITECTURE NAVALE		LE PLAN NORD 84220 GOULT david-henry@wanadoo.fr	