



NE	Lambert 4	Lambert 4
21	587552.1	183099.6
23	587533.4	183111.9
33	587491.5	183007.9
34	587503.4	183033.7

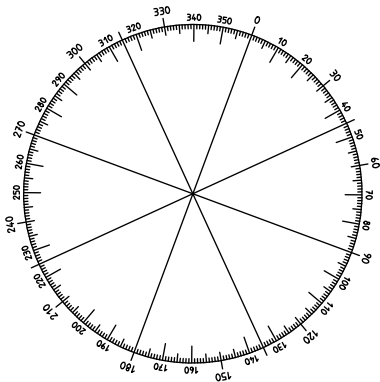

CÔTÉ NAVIRE & SEA-LINE

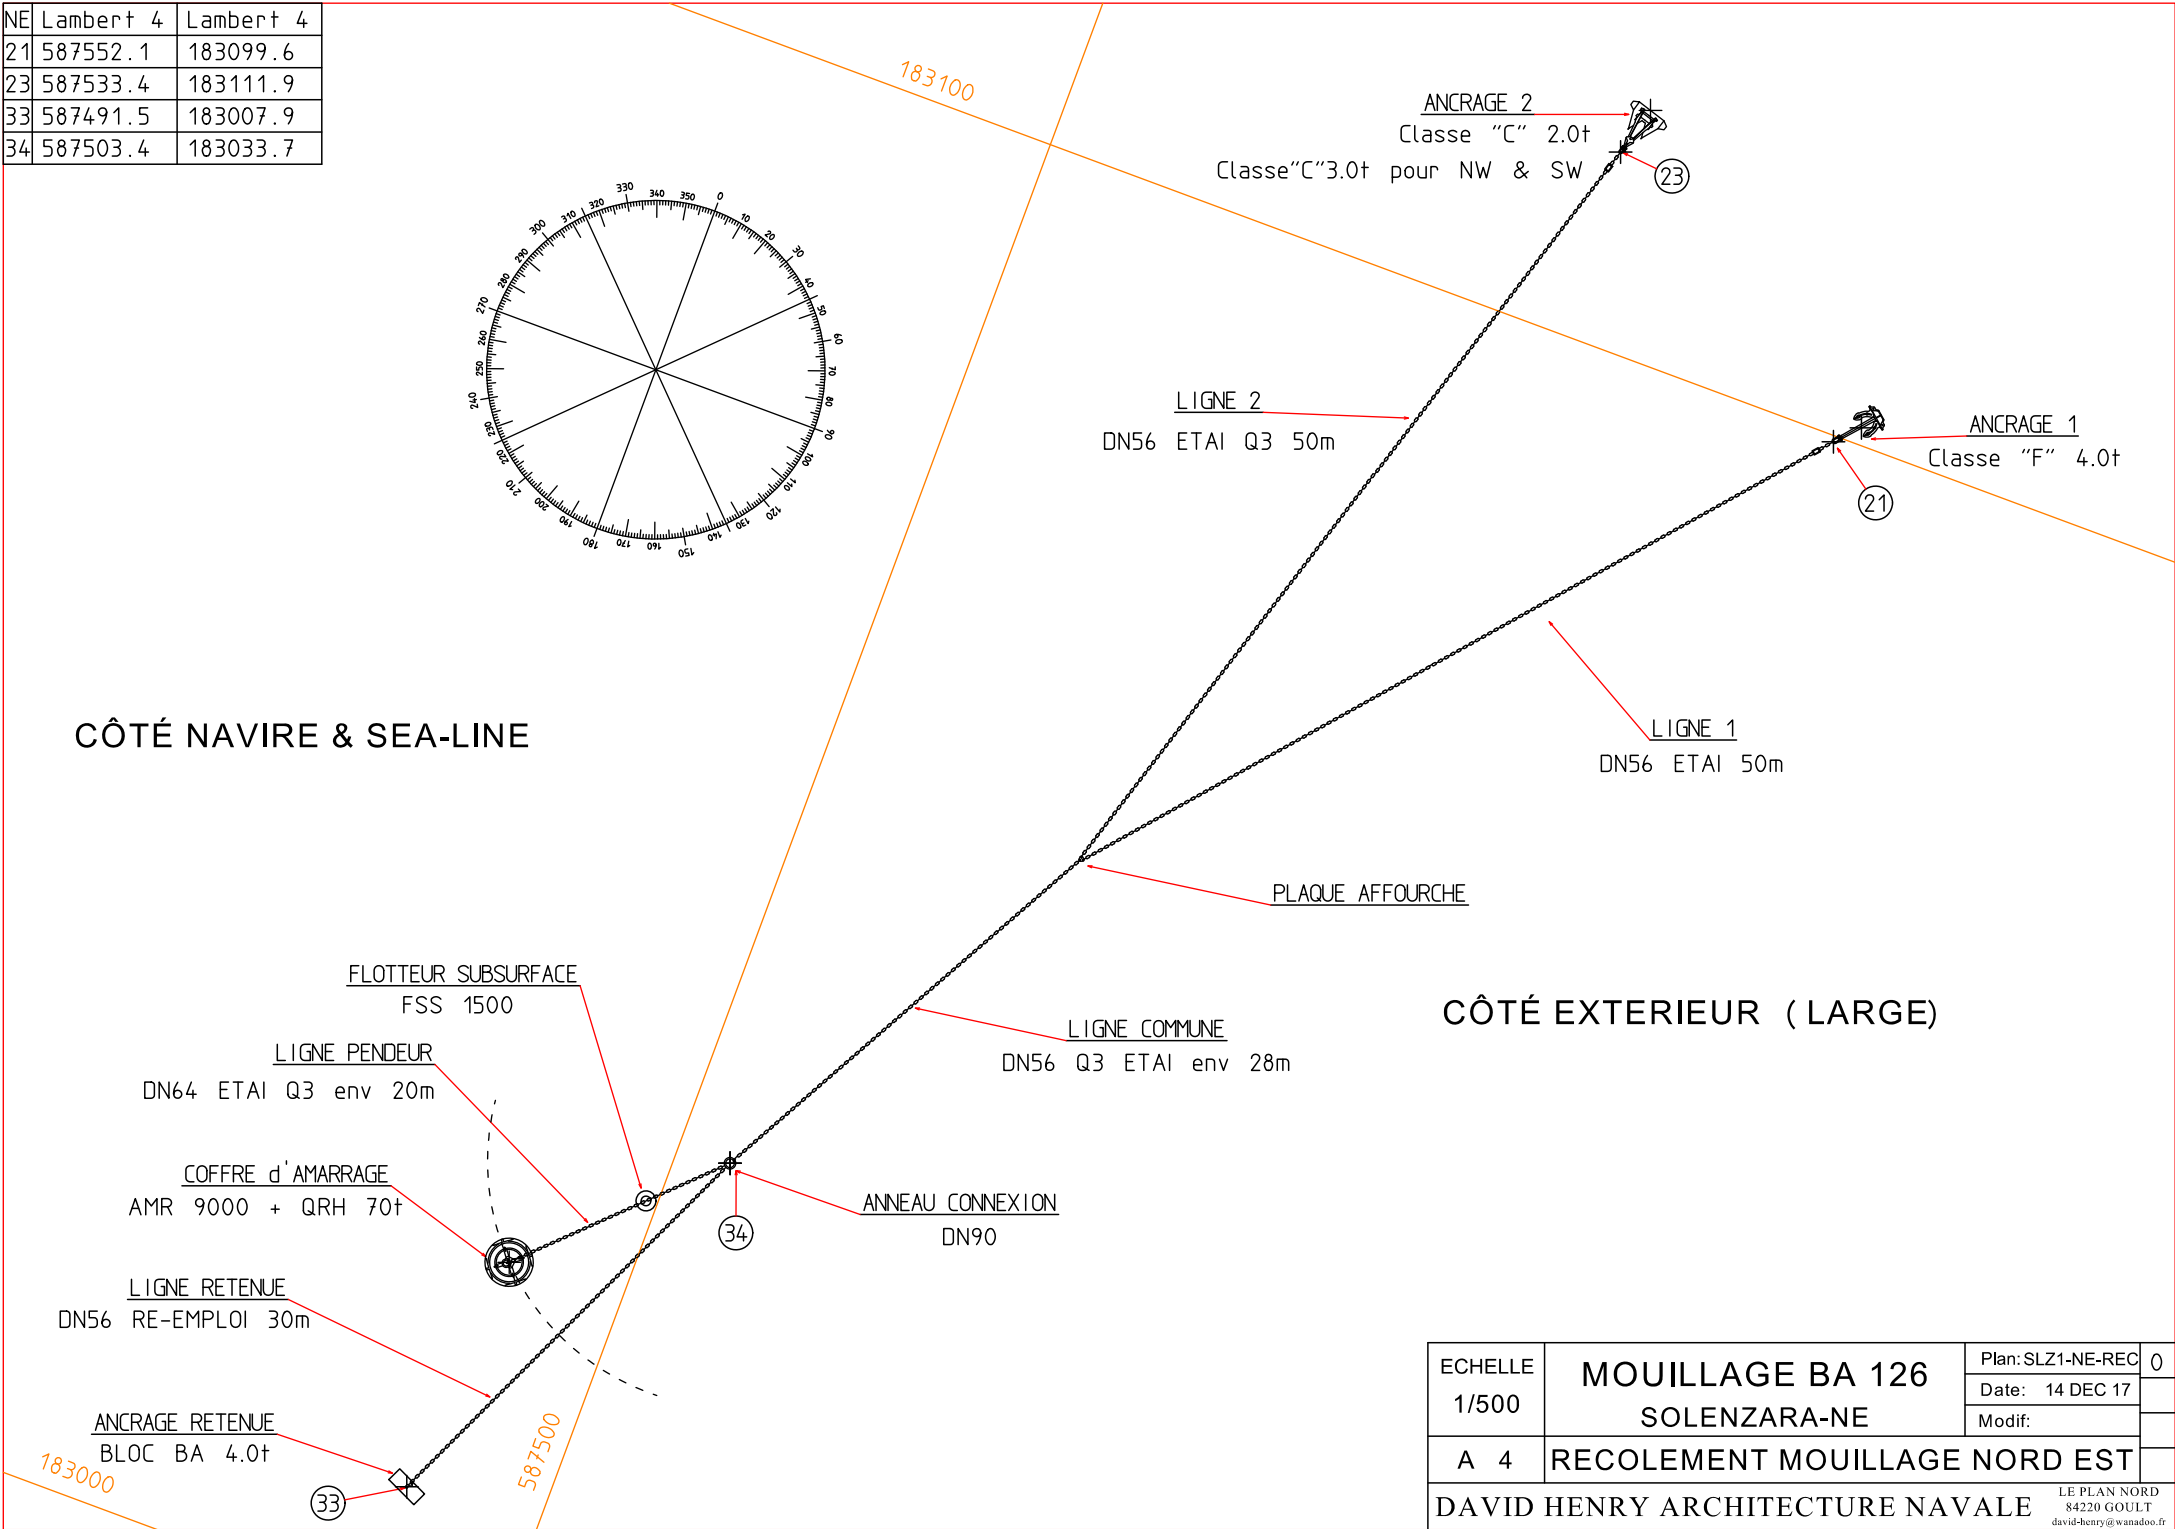

ECHELLE 1/500	MOUILLAGE BA 126 SOLENZARA-NE	Plan: SLZ1-NE-REC	0
		Date: 14 DEC 17	
		Modif:	
A 4	RECOLEMENT MOUILLAGE NORD EST		
DAVID HENRY ARCHITECTURE NAVALE		LE PLAN NORD 84220 GOULT david-henry@wanadoo.fr	