

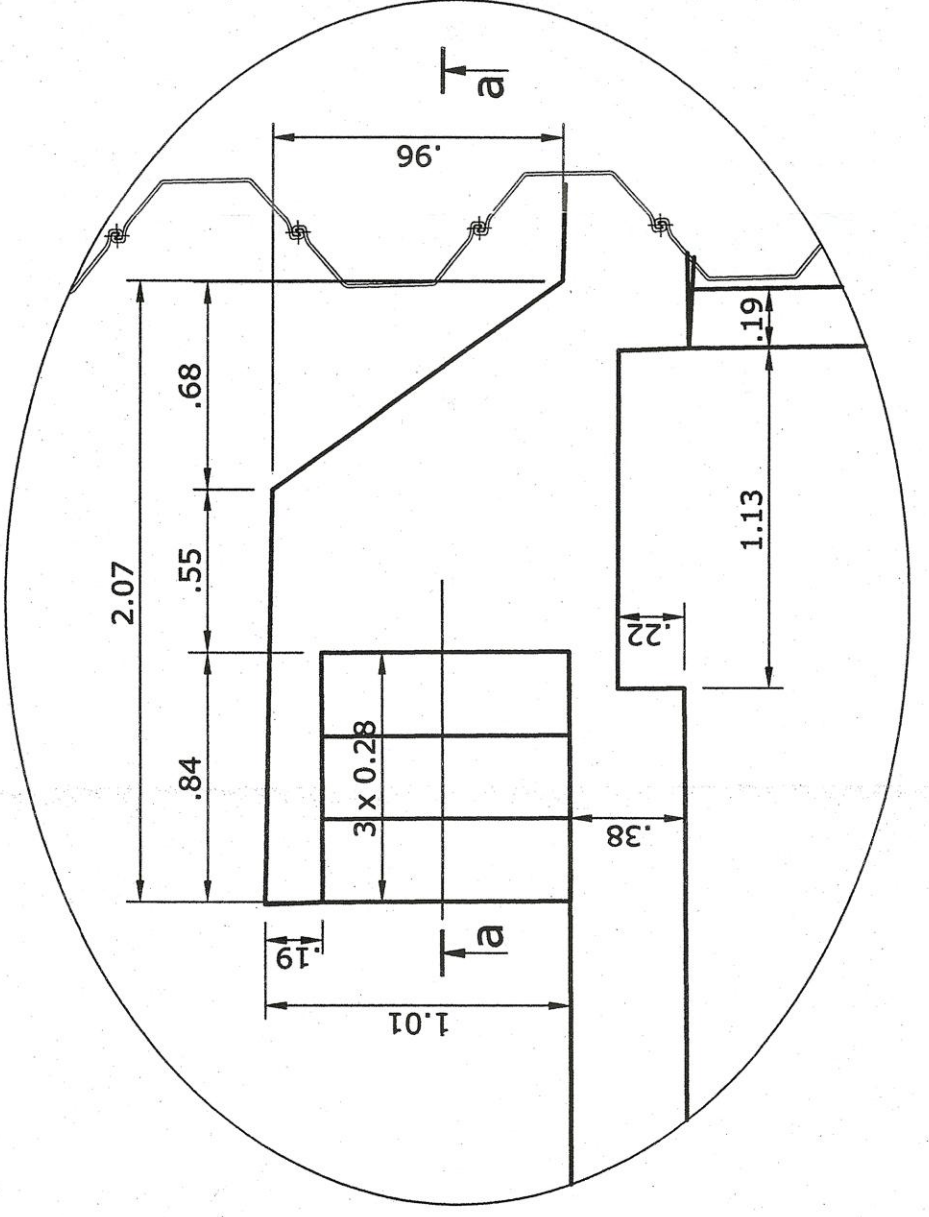
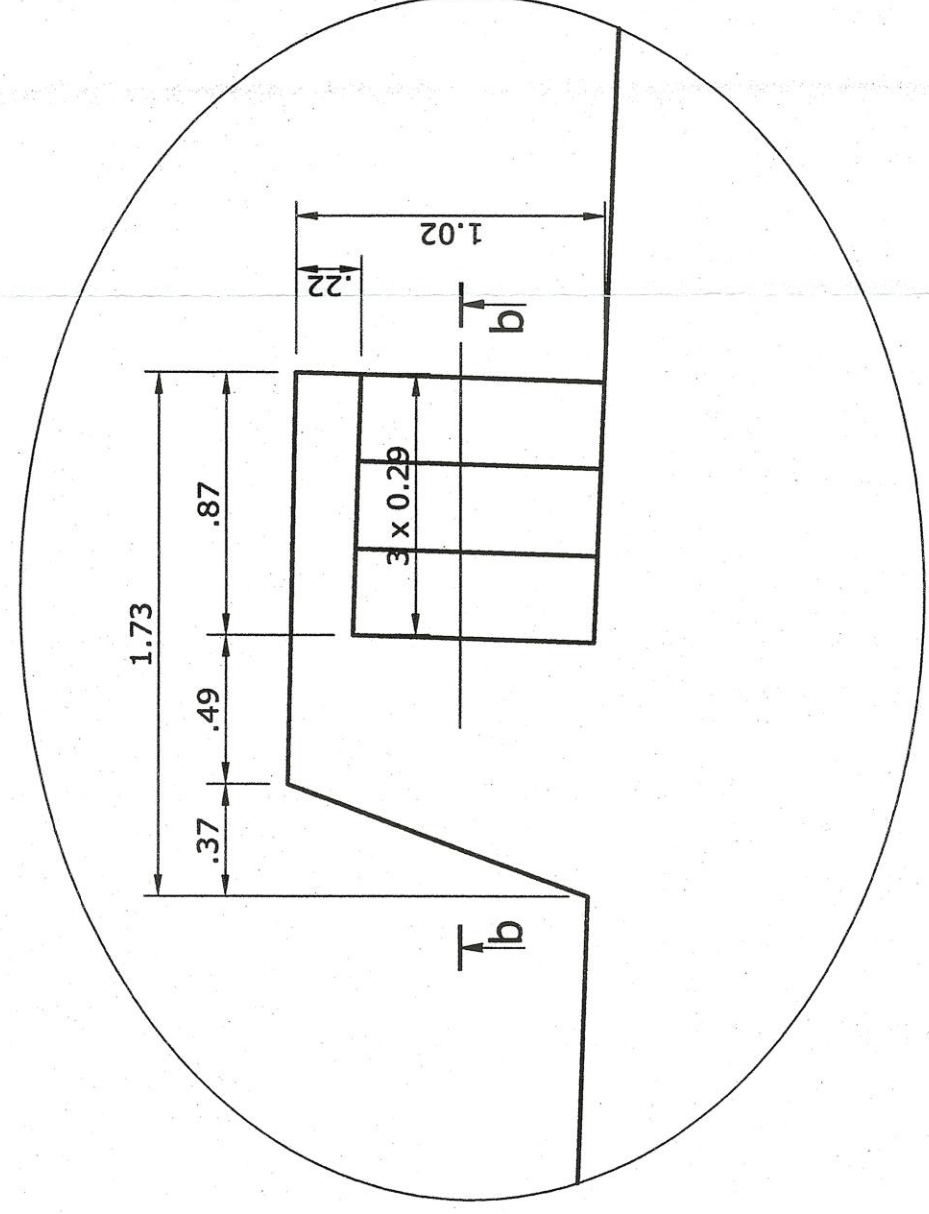
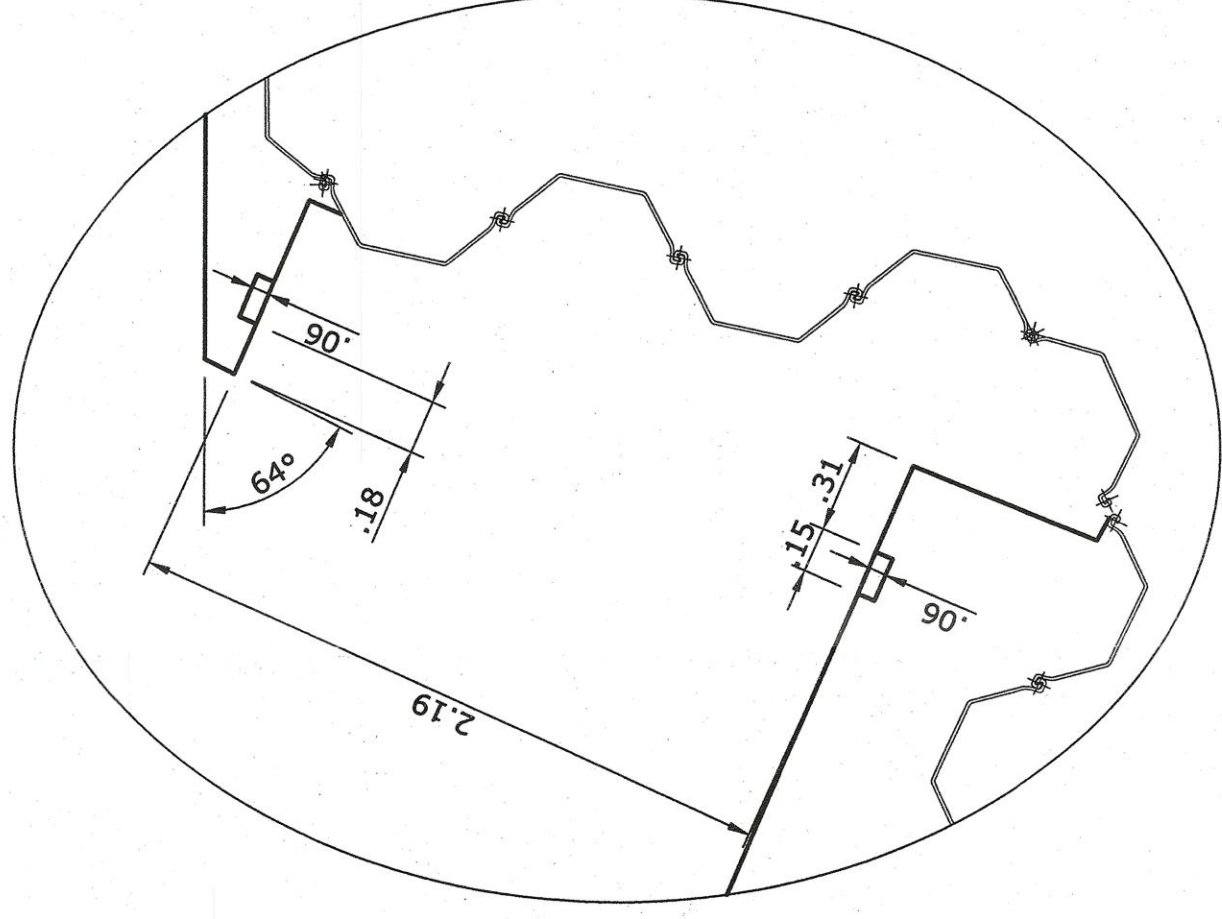
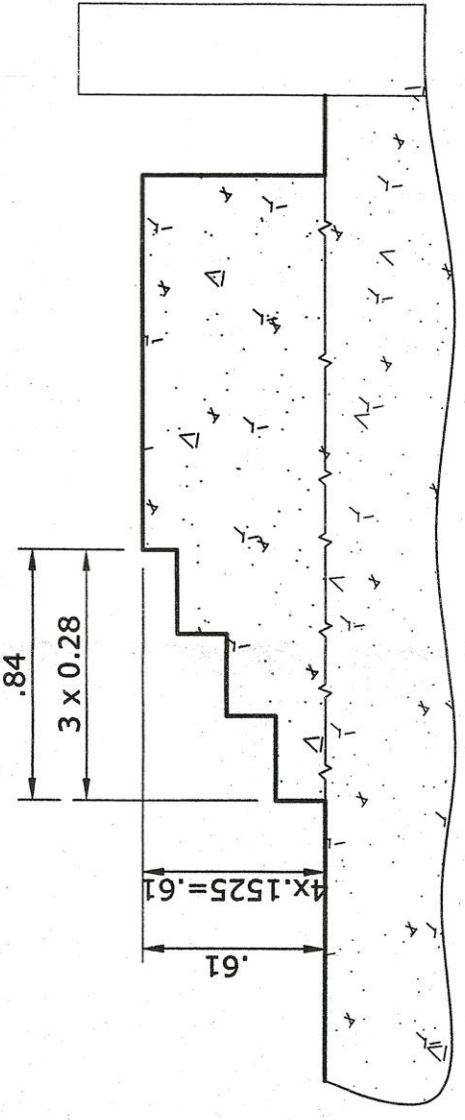
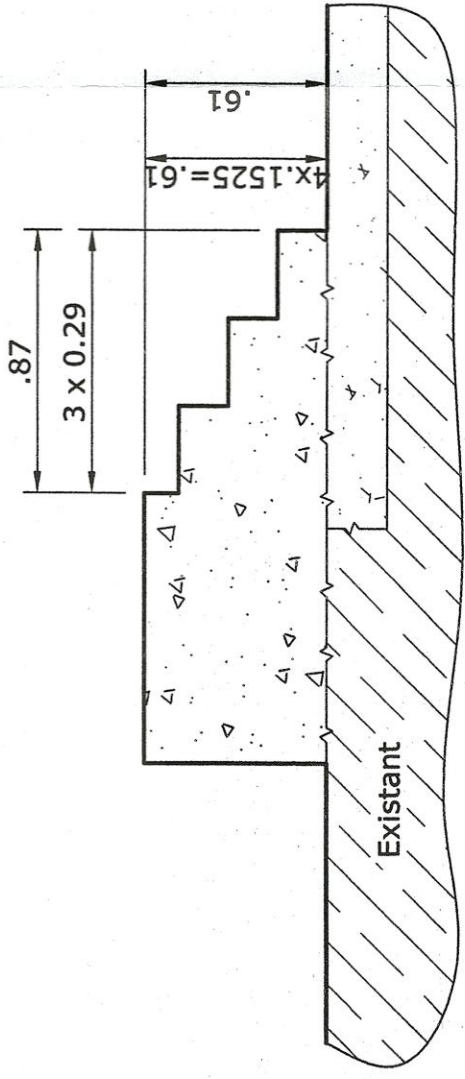


170.96

2.39

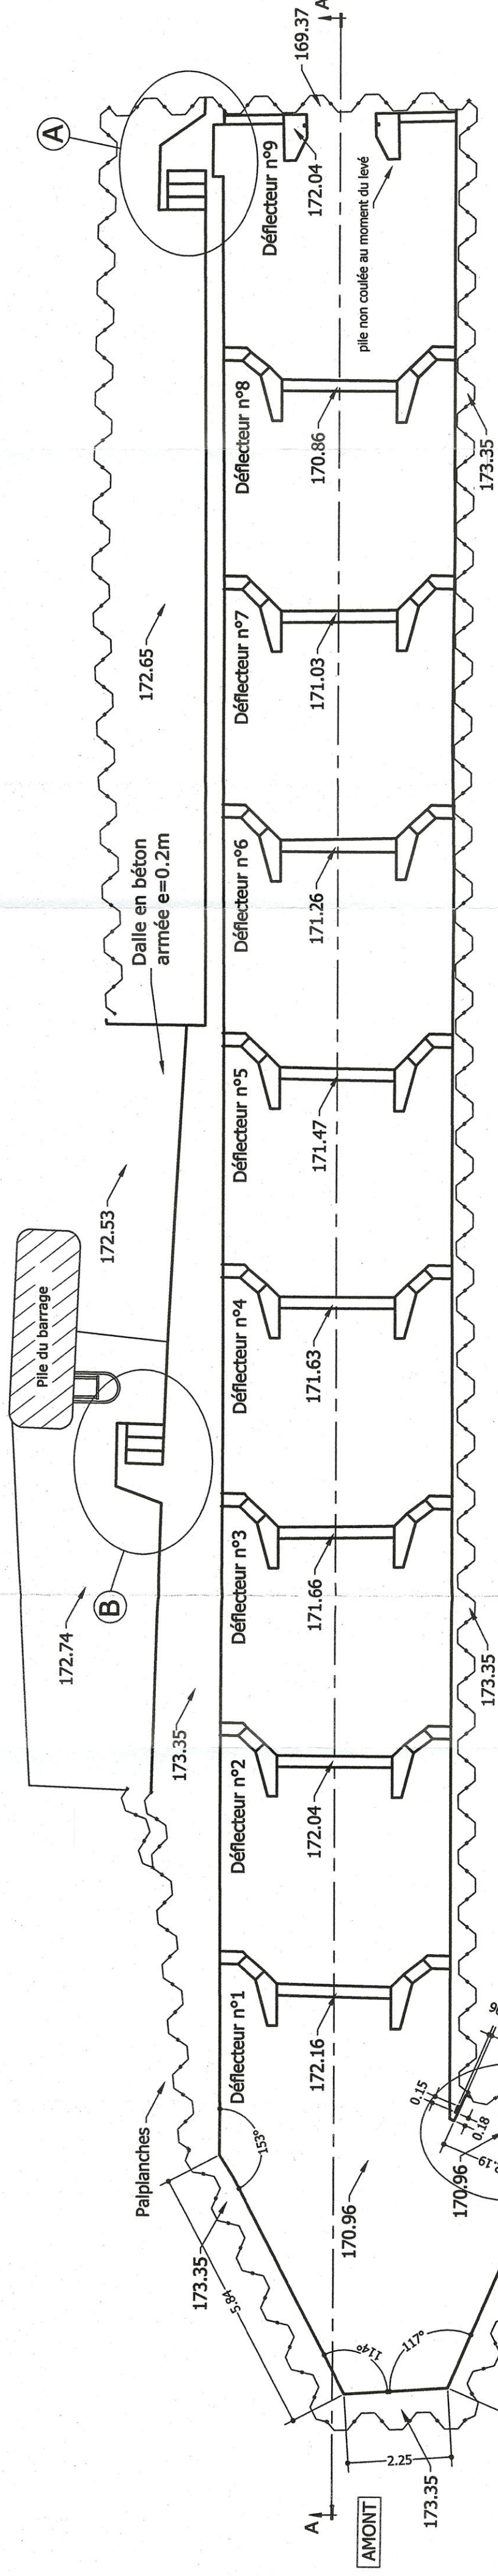

Vue en élévation de la passe à poissons Coupe A-A

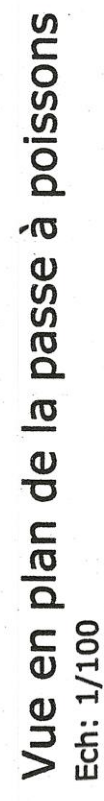

**TRAVAUX MARITIMES - TRAVAUX PUE**  
**TRAVAUX HYDRAULIQUES**  
80, route de Beaufort, RP 07

49180 St Barthélemy d'Anjou Cedex  
Tel: 02.41.18.12.18 - Fax: 02.41.93.72.56

**SECTEUR ILE DE FRANCE**

**Tél: 01.84.95.81.52 - Fax: 01.84.95.81.53**

4	NYO ACC-1-1-1	NYO E4-
---	---------------	---------

	05 007	15 15
--	--------	-------

25	607	154F
----	-----	------